


FILE NAME = K:\PROJECTS\52000's\52760\Presentation 08-14\GBOR-PLAN.dwg(PlanSST1)
DATE/TIME = Oct 17, 2014
USER = ikamornik


DESIGN SUPERVISOR Joseph Castagna JOB MANAGER Joseph Castagna DESIGNED BY Vincent Frisina CHECKED BY Joseph Castagna ESTIMATED BY Joseph Castagna DRAFTED BY Lyubov Kamornik CHECKED BY Joseph Castagna

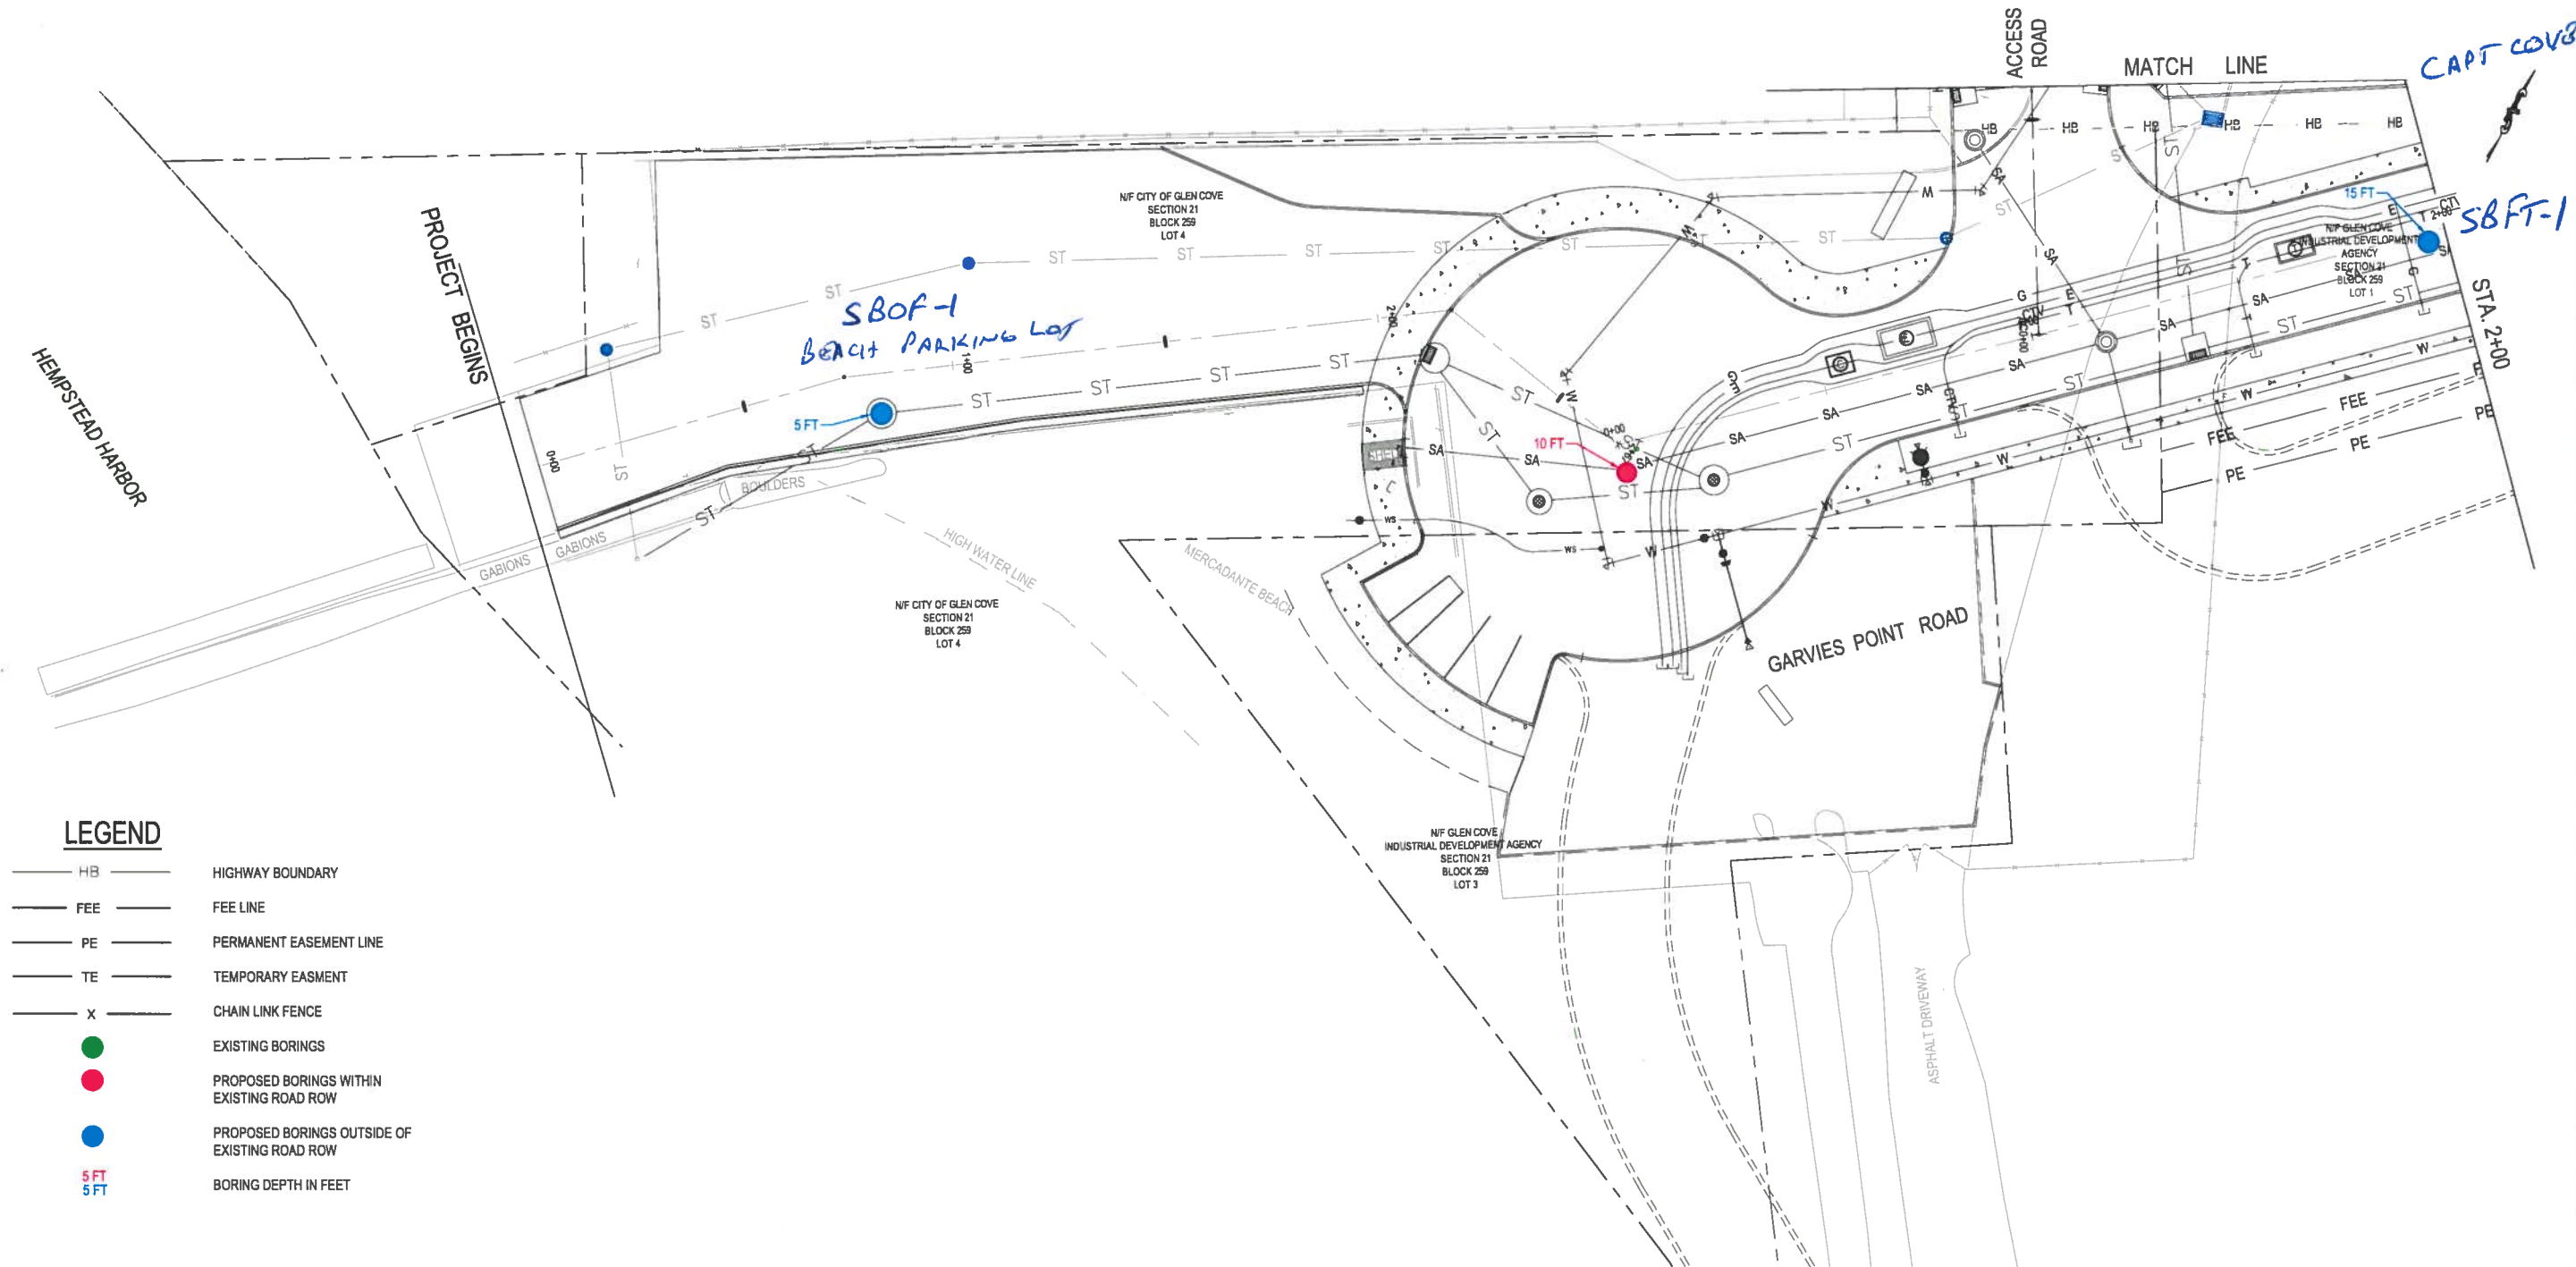

LEGEND

- HB HIGHWAY BOUNDARY
- FEE FEE LINE
- PE PERMANENT EASEMENT LINE
- TE TEMPORARY EASEMENT
- X CHAIN LINK FENCE
- EXISTING BORINGS
- PROPOSED BORINGS WITHIN EXISTING ROAD ROW
- PROPOSED BORINGS OUTSIDE OF EXISTING ROAD ROW
- 5 FT BORING DEPTH IN FEET
- 5 FT BORING DEPTH IN FEET

| | |
|--|--------------------|
| PREPARED BY: ON: | ALTERED BY: ON: |
| <div>XXXXXXXXXX, P.E. NYSPE LIC. NO. XXXXXX PARTNER XXXXXXXXXX</div> <div>DATE</div> | |

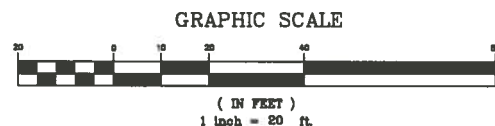

| | |
|--|------|
| AS BUILT REVISIONS DESCRIPTION OF WORK: | |
| SIGNATURE | DATE |

| | | |
|----------------|---------|----------|
| PIN | BRIDGES | CULVERTS |
| PS&E DATE | | |
| COUNTY: NASSAU | | |

| | |
|--|-------------------------------|
| ALL DIMENSIONS IN ft UNLESS OTHERWISE NOTED | CONTRACT NUMBER |
| CITY OF GLEN COVE BORING LOCATION PLAN GARVIES POINT ROAD / BOAT RAMP SHEET 1 | DRAWING NO. BP-1 SHEET NO. |




IT IS A VIOLATION OF LAW FOR ANY PERSON, UNLESS THEY ARE ACTING UNDER THE DIRECTION OF A LICENSED PROFESSIONAL ENGINEER, ARCHITECT, LANDSCAPING ARCHITECT, OR A LAND SURVEYOR, TO ALTER AN ITEM IN ANY WAY. IF AN ITEM BEARING THE STAMP OF A LICENSED PROFESSIONAL IS ALTERED, THE ALTERING ENGINEER, ARCHITECT, LANDSCAPING ARCHITECT, OR A LAND SURVEYOR SHALL STAMP THE DOCUMENT AND INCLUDE THE NOTATION "ALTERED BY" FOLLOWED BY THEIR SIGNATURE, THE DATE OF SUCH ALTERATION, AND A SPECIFIC DESCRIPTION OF THE ALTERATION.


FILE NAME = K:\PROJECTS\52000's\52760\Presentation 08-14\GBOR-PLAN.dwg(PlanSS2)
DATE/TIME = Oct. 17, 2014
USER = ikamornik

DESIGN SUPERVISOR Joseph Castagna JOB MANAGER Joseph Castagna DESIGNED BY Vincent Frisano CHECKED BY Joseph Castagna ESTIMATED BY

DRAFTED BY Lyubov Kamornik CHECKED BY Joseph Castagna

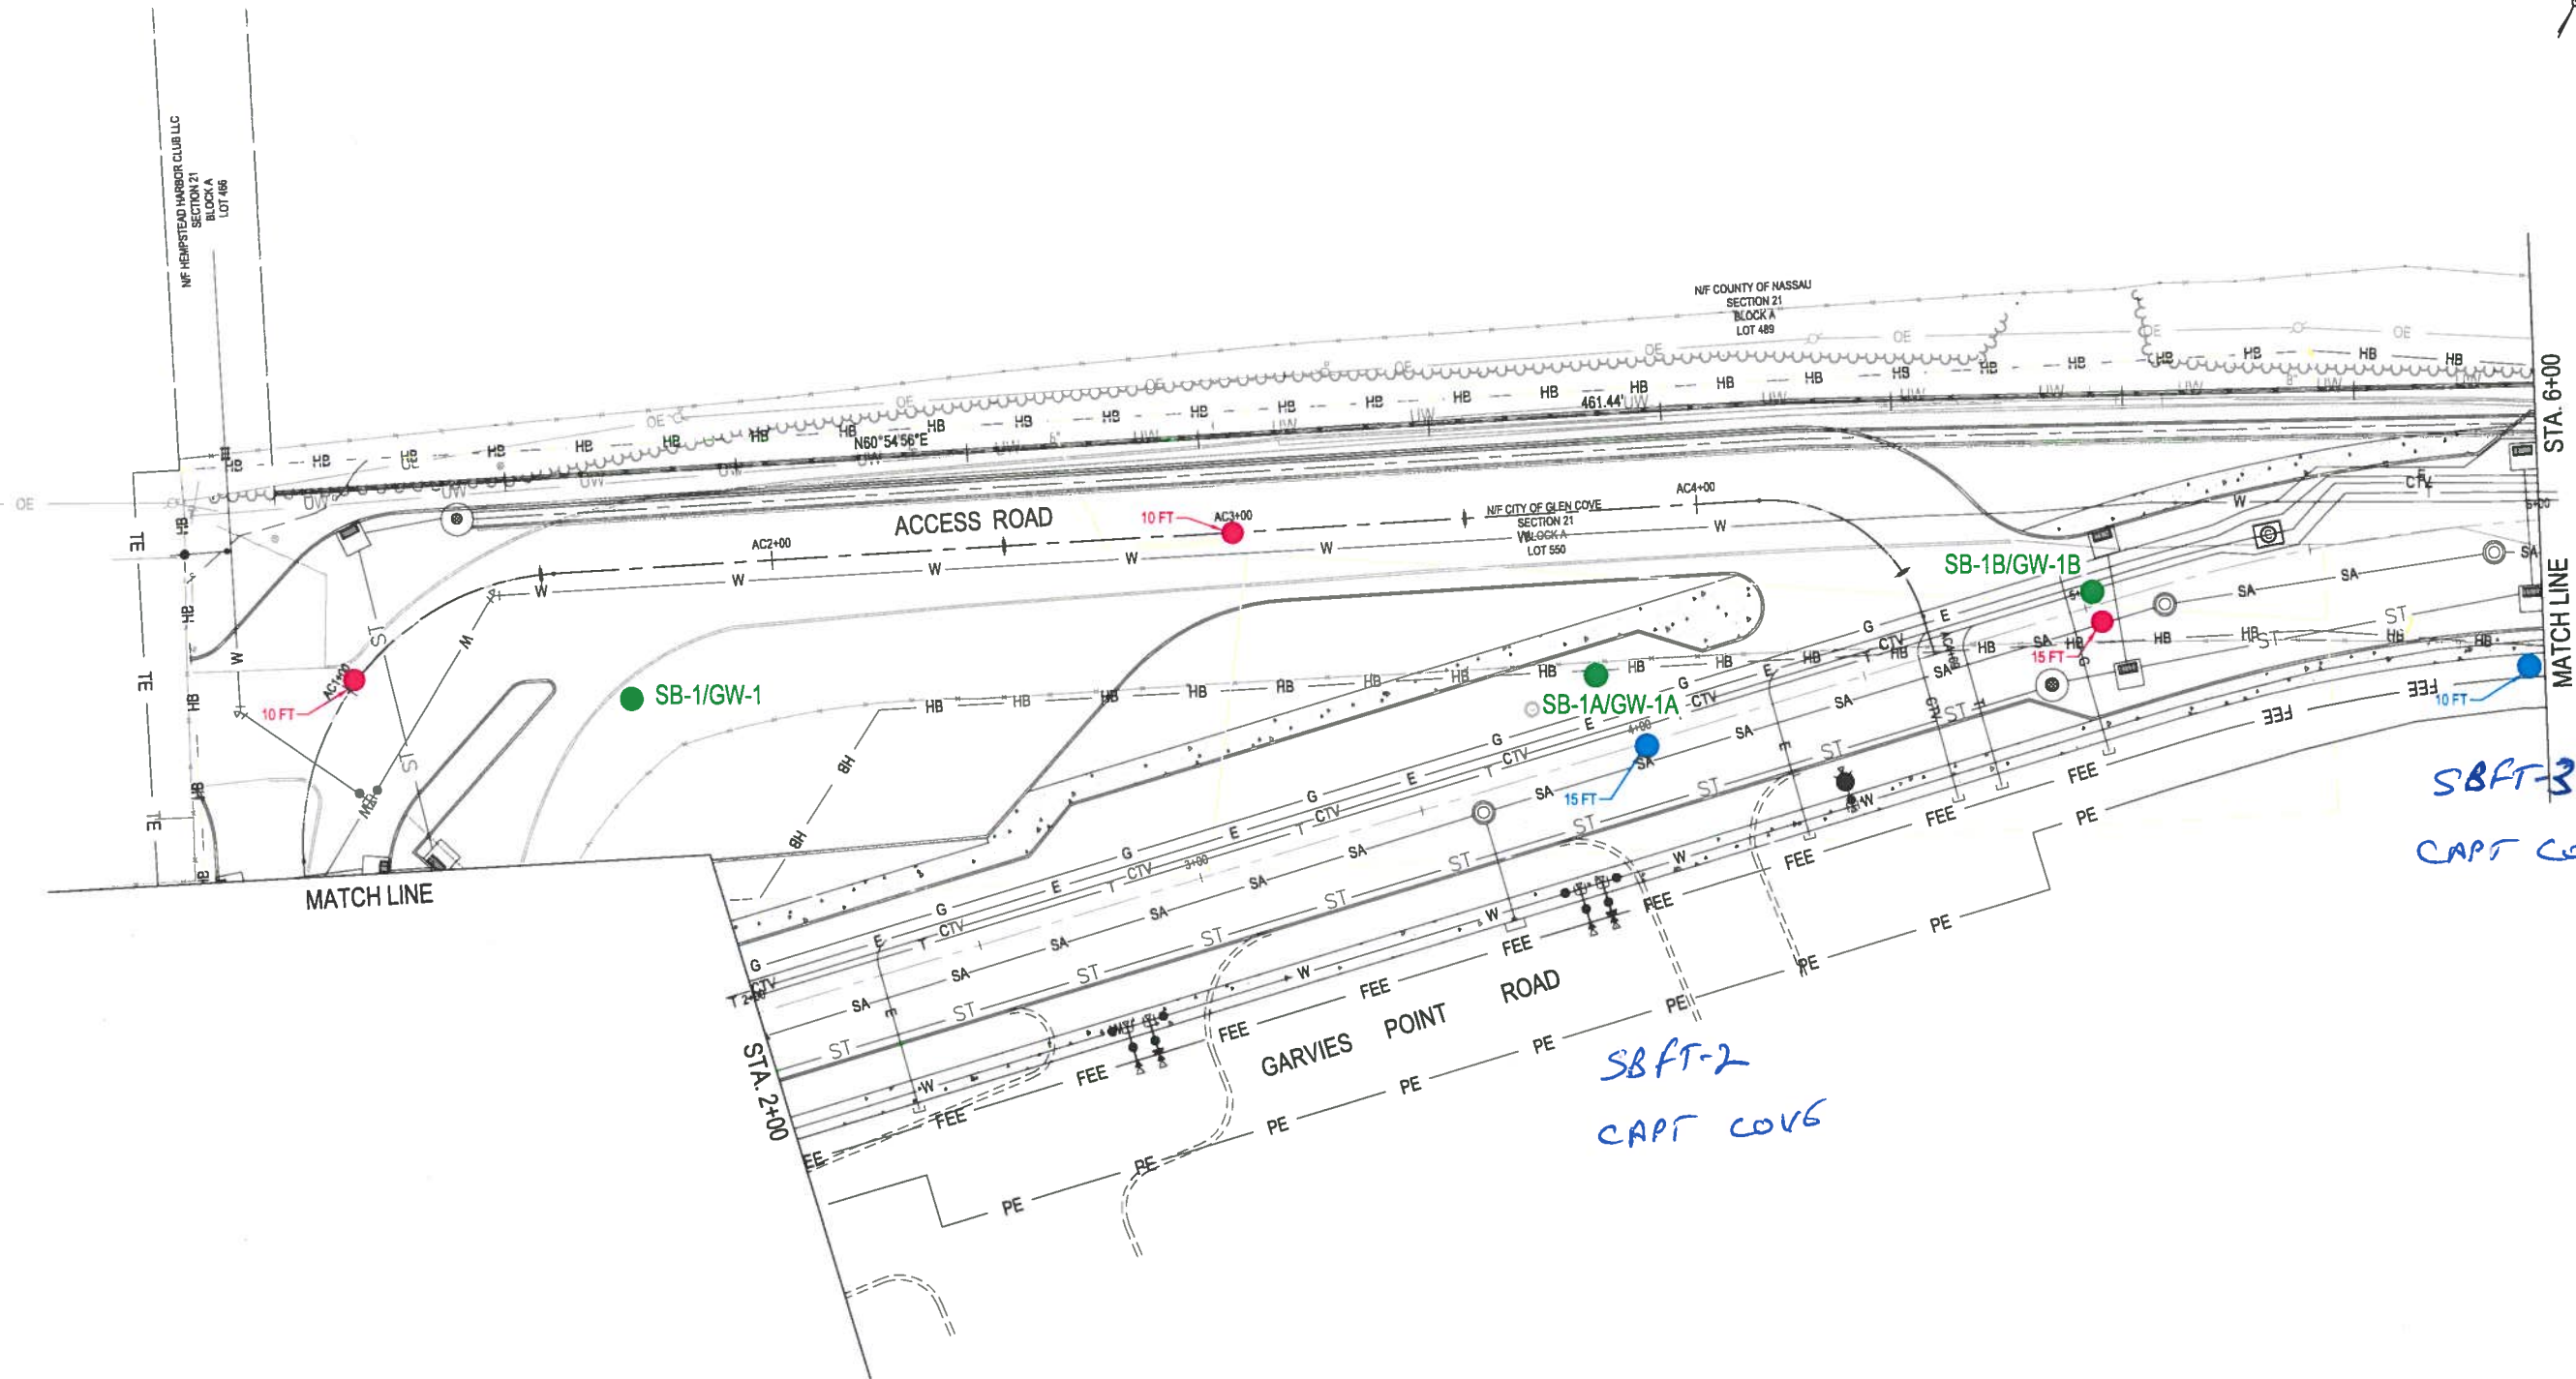

| | |
|---|--------------------|
| PREPARED BY: ON: | ALTERED BY: ON: |
| <div>XXXXXXXXXX, P.E. NYSPE LIC. NO. XXXXX PARTNER XXXXXXXXXX</div> <div>DATE</div> | |

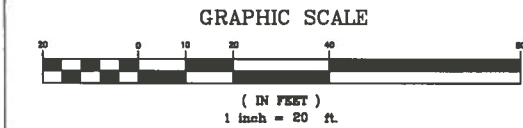

| | |
|--|------|
| AS BUILT REVISIONS DESCRIPTION OF WORK: | |
| SIGNATURE | DATE |

IT IS A VIOLATION OF LAW FOR ANY PERSON, UNLESS THEY ARE ACTING UNDER THE DIRECTION OF A LICENSED PROFESSIONAL ENGINEER, ARCHITECT, LANDSCAPING ARCHITECT, OR A LAND SURVEYOR, TO ALTER AN ITEM IN ANY WAY. IF AN ITEM BEARING THE STAMP OF A LICENSED PROFESSIONAL IS ALTERED, THE ALTERING ENGINEER, ARCHITECT, LANDSCAPING ARCHITECT, OR A LAND SURVEYOR SHALL STAMP THE DOCUMENT AND INCLUDE THE NOTATION "ALTERED BY" FOLLOWED BY THEIR SIGNATURE, THE DATE OF SUCH ALTERATION, AND A SPECIFIC DESCRIPTION OF THE ALTERATION.

| | | |
|----------------|---------|----------|
| PIN | BRIDGES | CULVERTS |
| PS&E DATE | | |
| COUNTY: NASSAU | | |

| | |
|--|-------------------------------|
| ALL DIMENSIONS IN ft UNLESS OTHERWISE NOTED | CONTRACT NUMBER |
| CITY OF GLEN COVE BORING LOCATION PLAN GARVIES POINT ROAD / ACCESS ROAD SHEET 2 | DRAWING NO. BP-2 SHEET NO. |






Gannett Fleming


FILE NAME = K:\PROJECTS\52000\52760\Presentation 08-14\GBOR-PLAN.dwg(PlanSS4)
DATE/TIME = Oct 17, 2014
USER = ikamornik

DESIGN SUPERVISOR Joseph Castagna JOB MANAGER Joseph Castagna DESIGNED BY Vincent Frisano CHECKED BY Joseph Castagna ESTIMATED BY Joseph Castagna DRAFTED BY Lubov Kamornik

CHECKED BY Joseph Castagna DRAFTED BY Lubov Kamornik

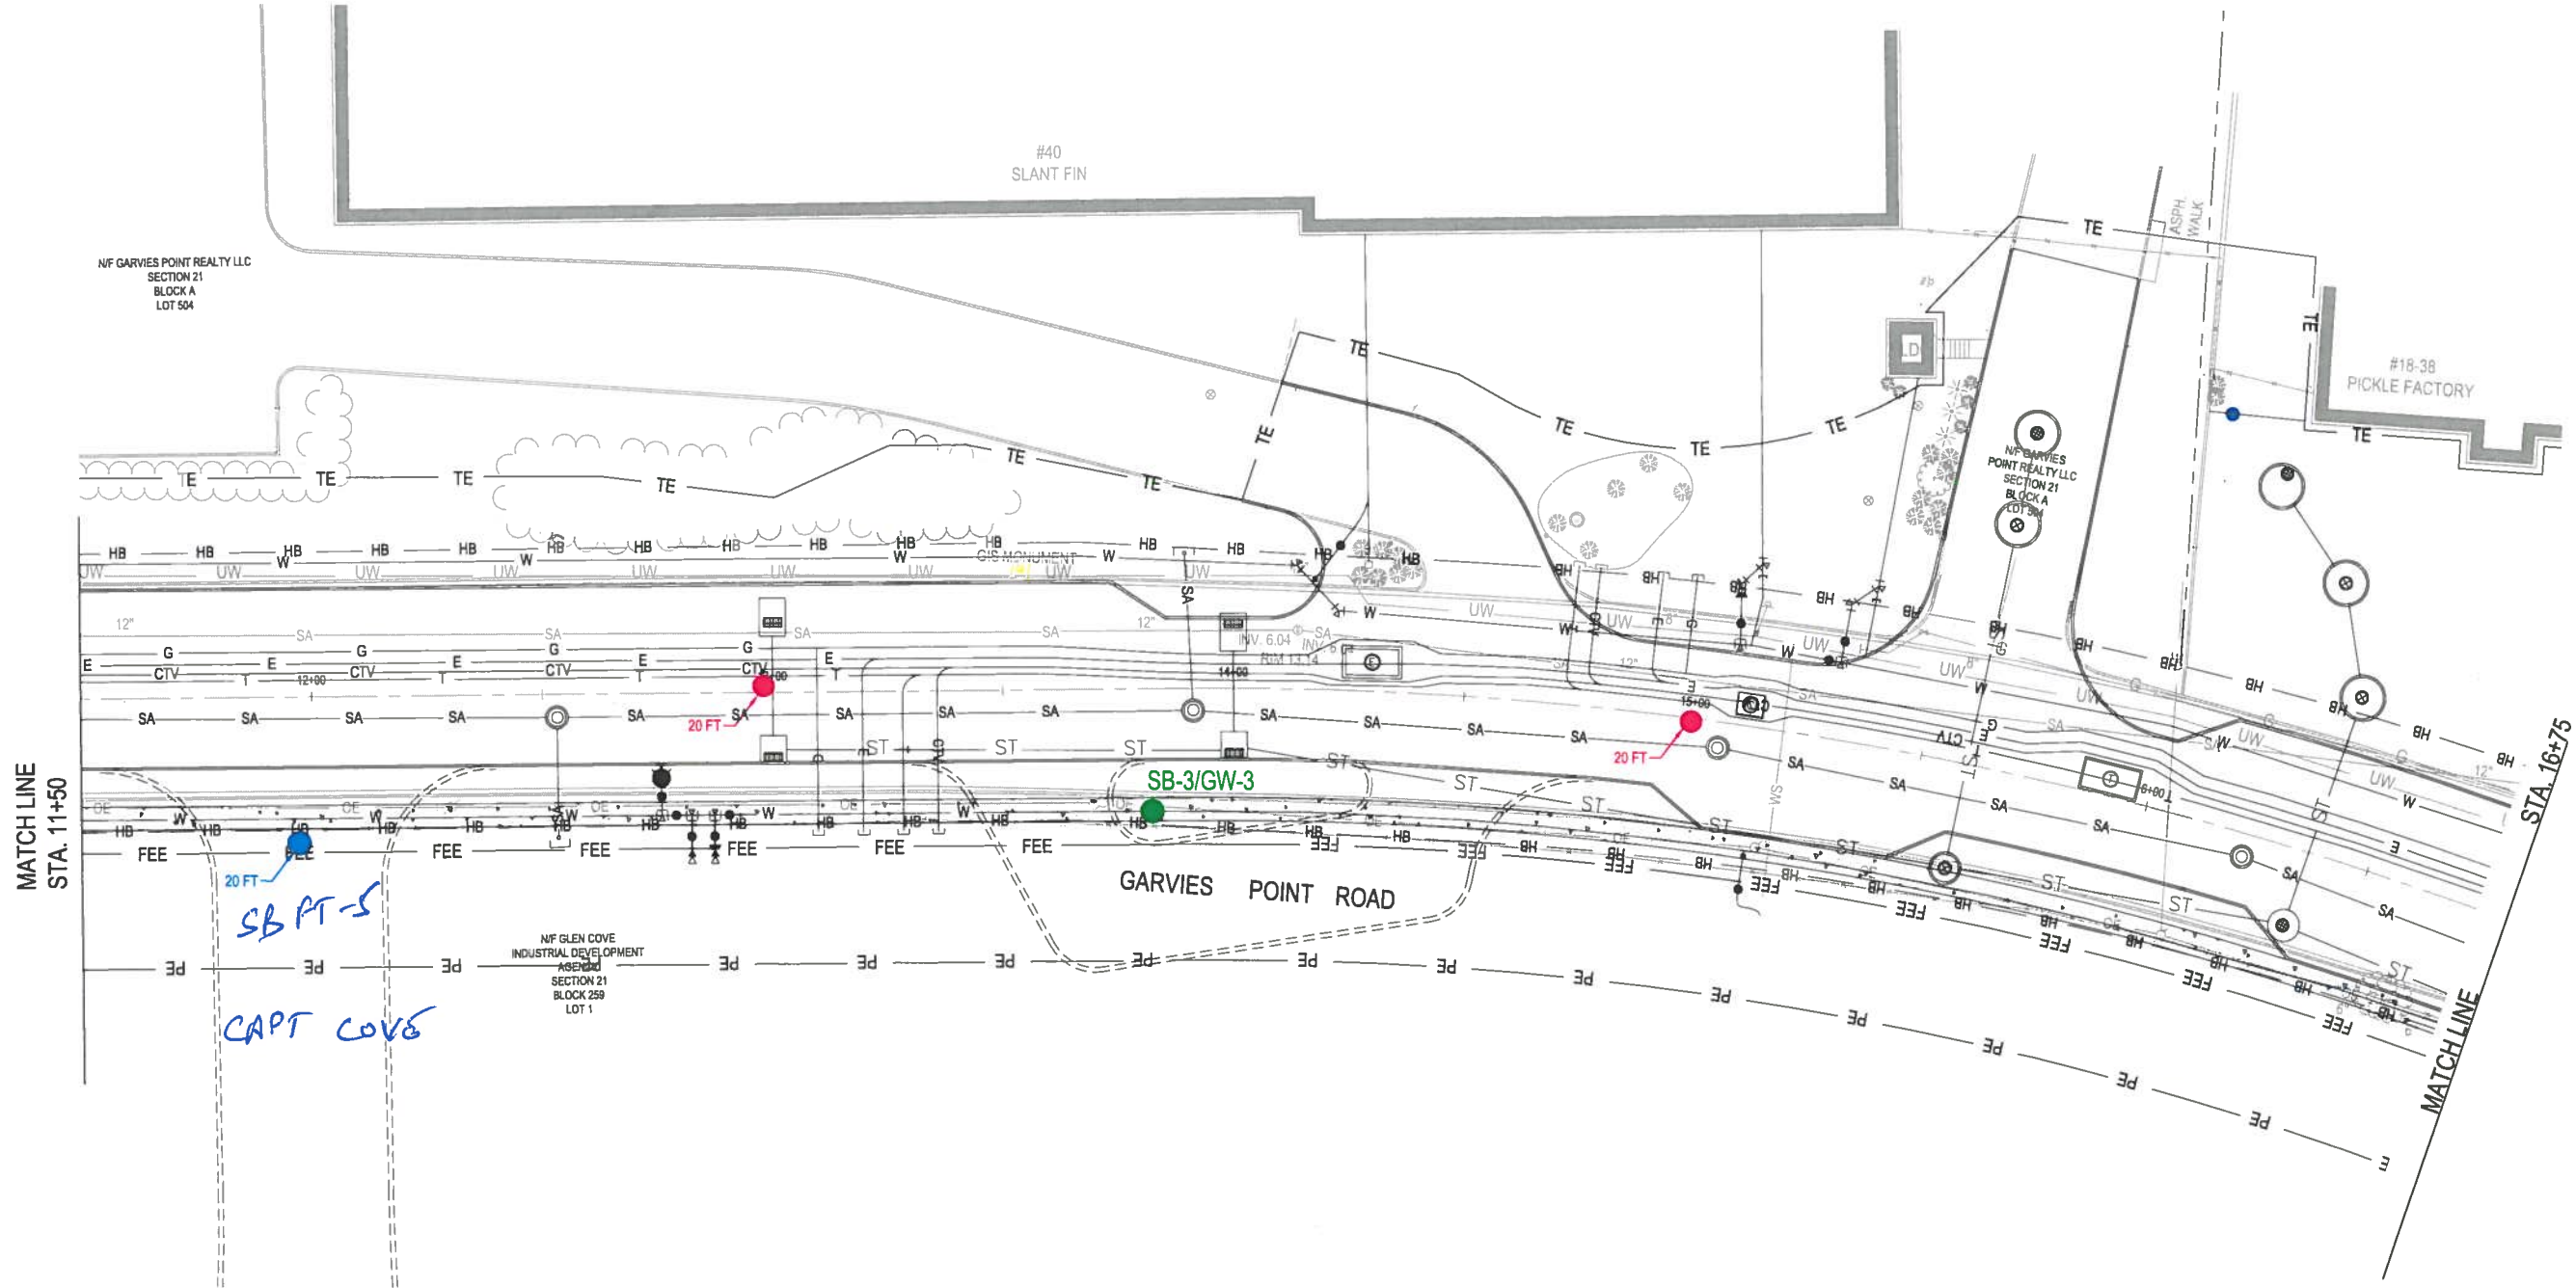

| | |
|---|--------------------|
| PREPARED BY: ON: | ALTERED BY: ON: |
| <div>XXXXXXXXXX, P.E. NYSPE Lic. No. XXXXX PARTNER XXXXXXXXXX</div> <div>DATE</div> | |

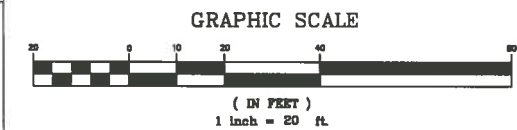

| | |
|--|------|
| AS BUILT REVISIONS DESCRIPTION OF WORK: | |
| SIGNATURE | DATE |

IT IS A VIOLATION OF LAW FOR ANY PERSON, UNLESS THEY ARE ACTING UNDER THE DIRECTION OF A LICENSED PROFESSIONAL ENGINEER, ARCHITECT, LANDSCAPING ARCHITECT, OR A LAND SURVEYOR, TO ALTER AN ITEM IN ANY WAY. IF AN ITEM BEARING THE STAMP OF A LICENSED PROFESSIONAL IS ALTERED, THE ALTERING ENGINEER, ARCHITECT, LANDSCAPING ARCHITECT, OR A LAND SURVEYOR SHALL STAMP THE DOCUMENT AND INCLUDE THE NOTATION 'ALTERED BY' FOLLOWED BY THEIR SIGNATURE, THE DATE OF SUCH ALTERATION, AND A SPECIFIC DESCRIPTION OF THE ALTERATION.

| | |
|----------------|--|
| PIN | |
| PS&E DATE | |
| COUNTY: NASSAU | |


| | | | |
|---------|----------|---|-------------------------------|
| BRIDGES | CULVERTS | ALL DIMENSIONS IN ft UNLESS OTHERWISE NOTED | CONTRACT NUMBER |
| | | CITY OF GLEN COVE BORING LOCATION PLAN GARVIE'S POINT ROAD SHEET 4 | DRAWING NO. BP-4 SHEET NO. |




FILE NAME = K:\PROJECTS\52000\52760\Presentation 08-14\GBOR-PLAN.dwg(PlanSS5)
DATE/TIME = Oct 17, 2014
USER = ikornnik

DESIGN SUPERVISOR Joseph Castagna JOB MANAGER Joseph Castagna DESIGNED BY Vincent Frisina CHECKED BY Joseph Castagna ESTIMATED BY

DRAFTED BY Lyubov kamornik CHECKED BY Joseph Castagna

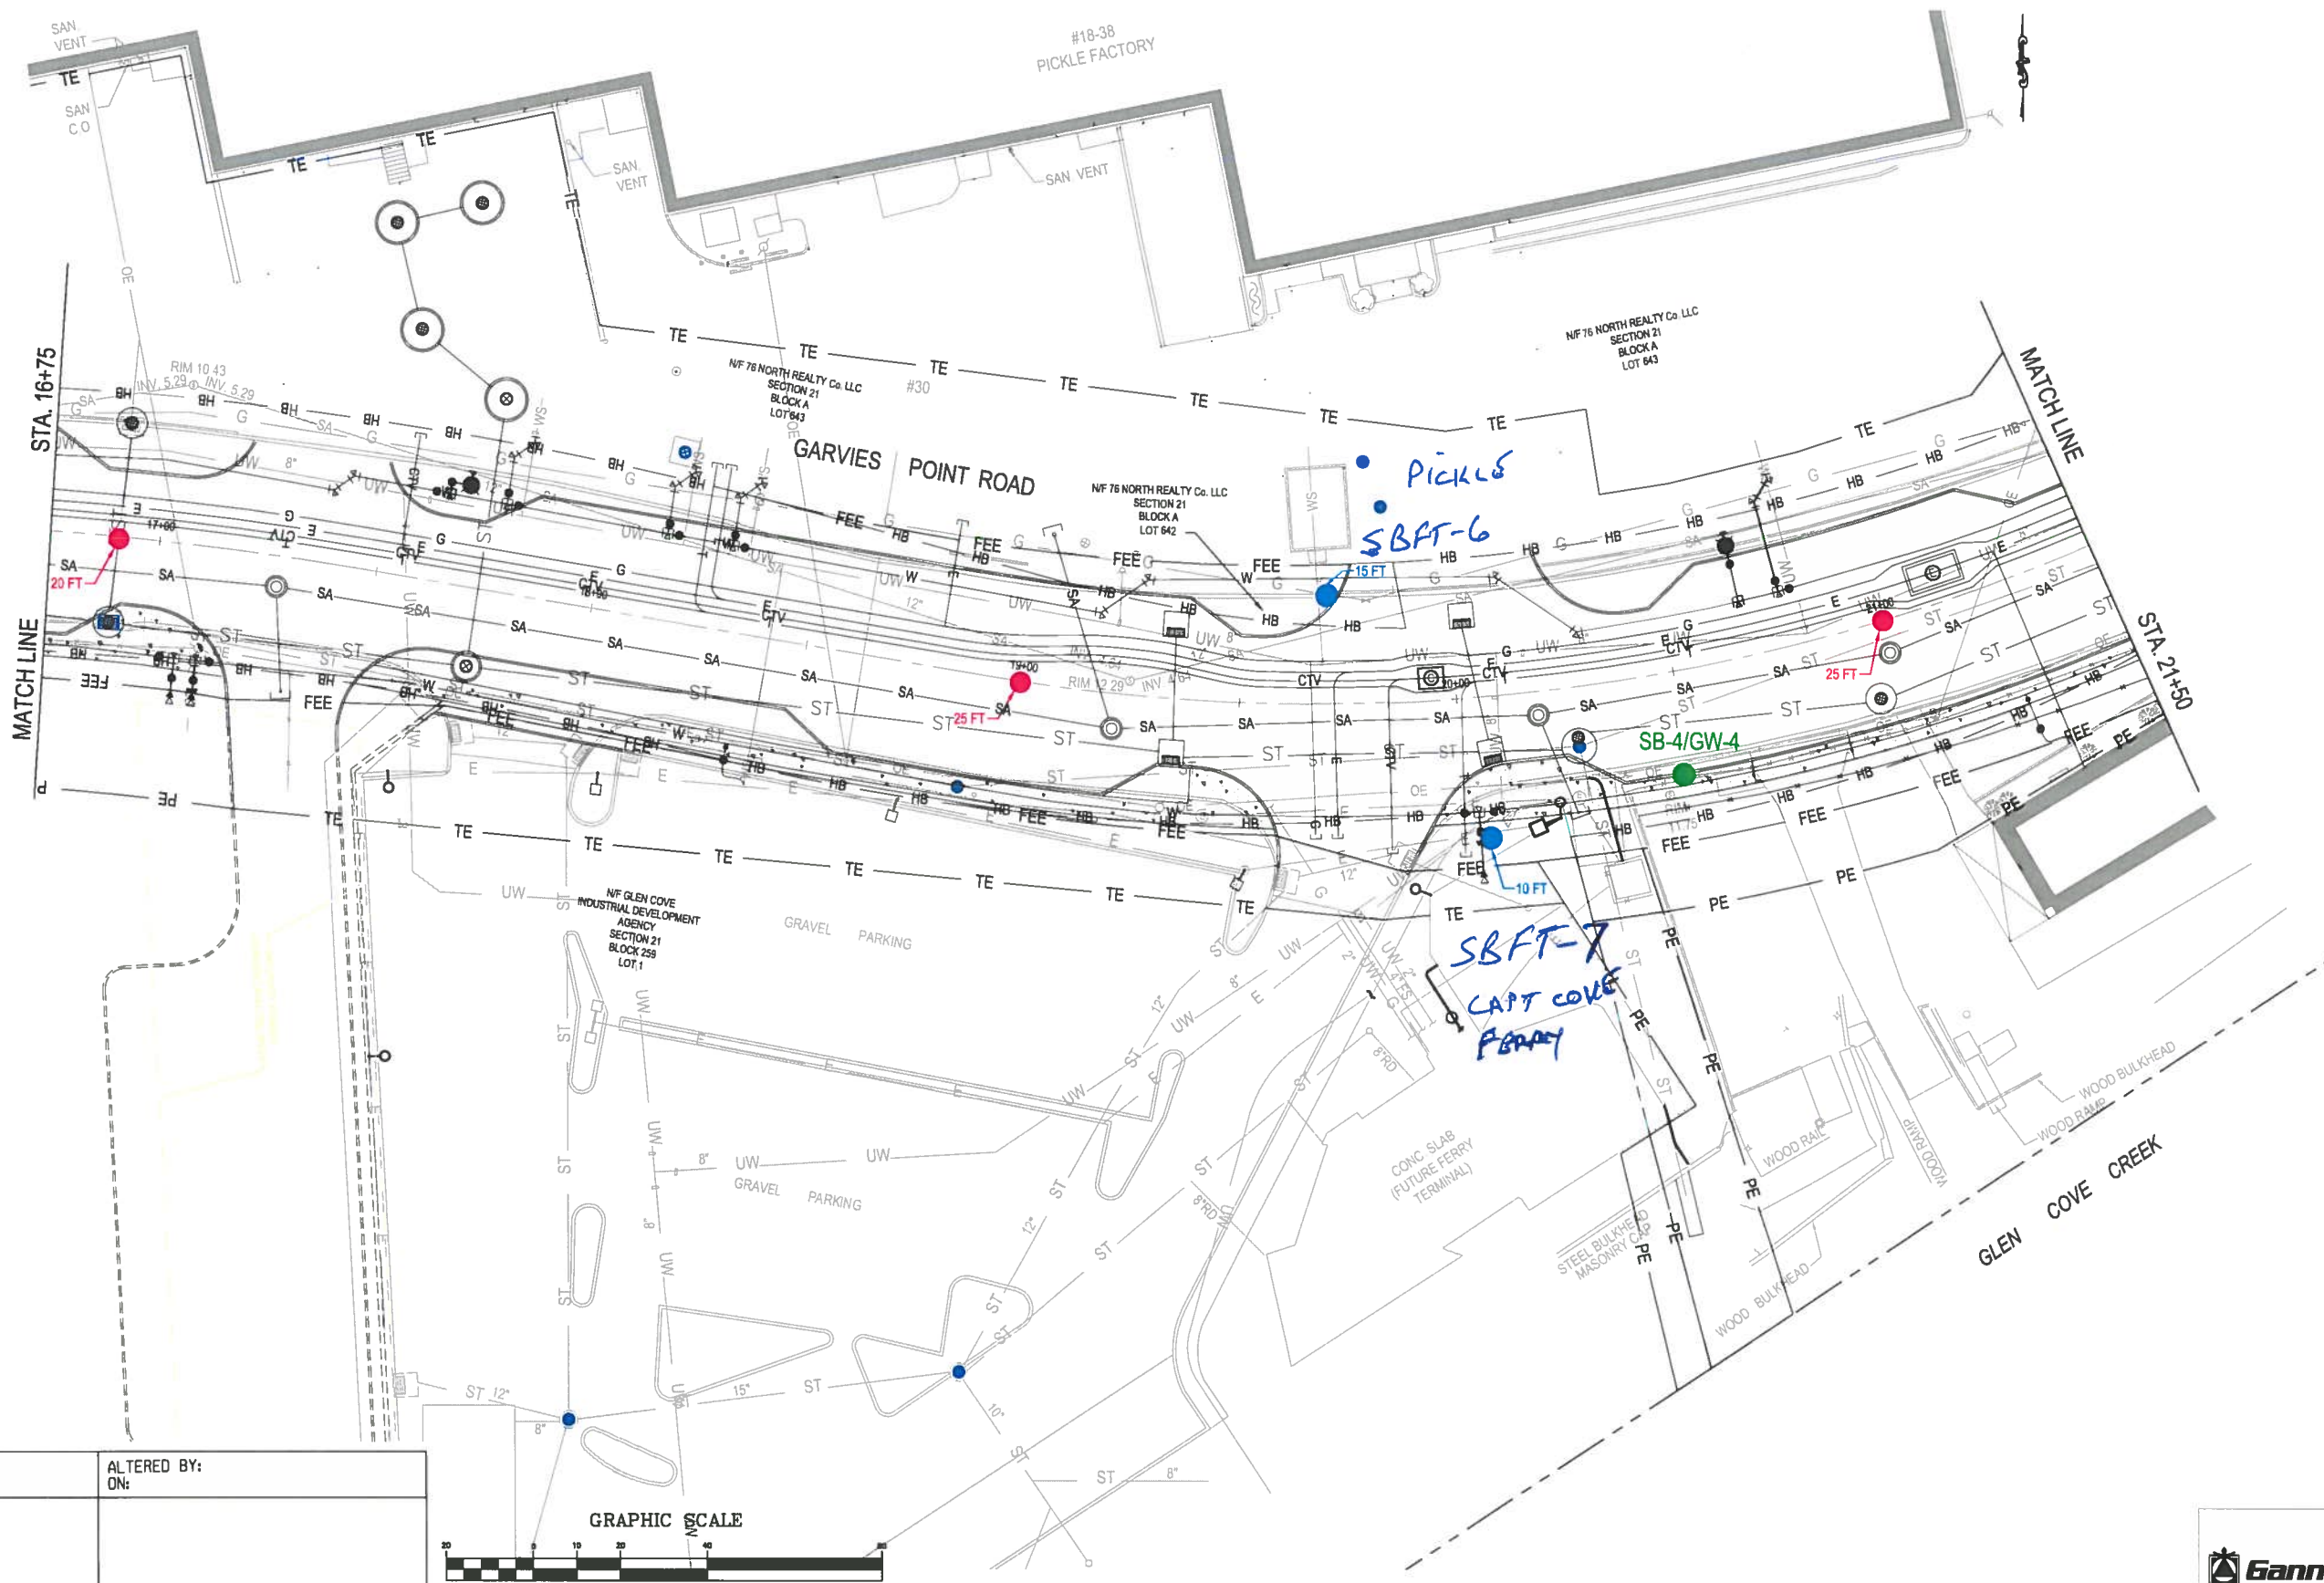

| | |
|---|--------------------|
| PREPARED BY: ON: | ALTERED BY: ON: |
| <div>XXXXXXXXXX, P.E. NYSPB LIC. NO. XXXXX PARTNER XXXXXXXXXX</div> <div>DATE</div> | |

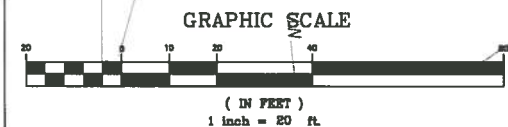


| | |
|--|------|
| AS BUILT REVISIONS DESCRIPTION OF WORK: | |
| SIGNATURE | DATE |



IT IS A VIOLATION OF LAW FOR ANY PERSON, UNLESS THEY ARE ACTING UNDER THE DIRECTION OF A LICENSED PROFESSIONAL ENGINEER, ARCHITECT, LANDSCAPING ARCHITECT, OR A LAND SURVEYOR, TO ALTER AN ITEM IN ANY WAY. IF AN ITEM BEARING THE STAMP OF A LICENSED PROFESSIONAL IS ALTERED, THE ALTERING ENGINEER, ARCHITECT, LANDSCAPING ARCHITECT, OR A LAND SURVEYOR SHALL STAMP THE DOCUMENT AND INCLUDE THE NOTATION "ALTERED BY" FOLLOWED BY THEIR SIGNATURE, THE DATE OF SUCH ALTERATION, AND A SPECIFIC DESCRIPTION OF THE ALTERATION.

| |
|----------------|
| PIN |
| PS&E DATE |
| COUNTY: NASSAU |

| | | | |
|--|----------|---|-------------------------------|
| BRIDGES | CULVERTS | ALL DIMENSIONS IN ft UNLESS OTHERWISE NOTED | CONTRACT NUMBER |
| CITY OF GLEN COVE BORING LOCATION PLAN GARVIES POINT ROAD SHEET 5 | | | DRAWING NO. BP-5 SHEET NO. |

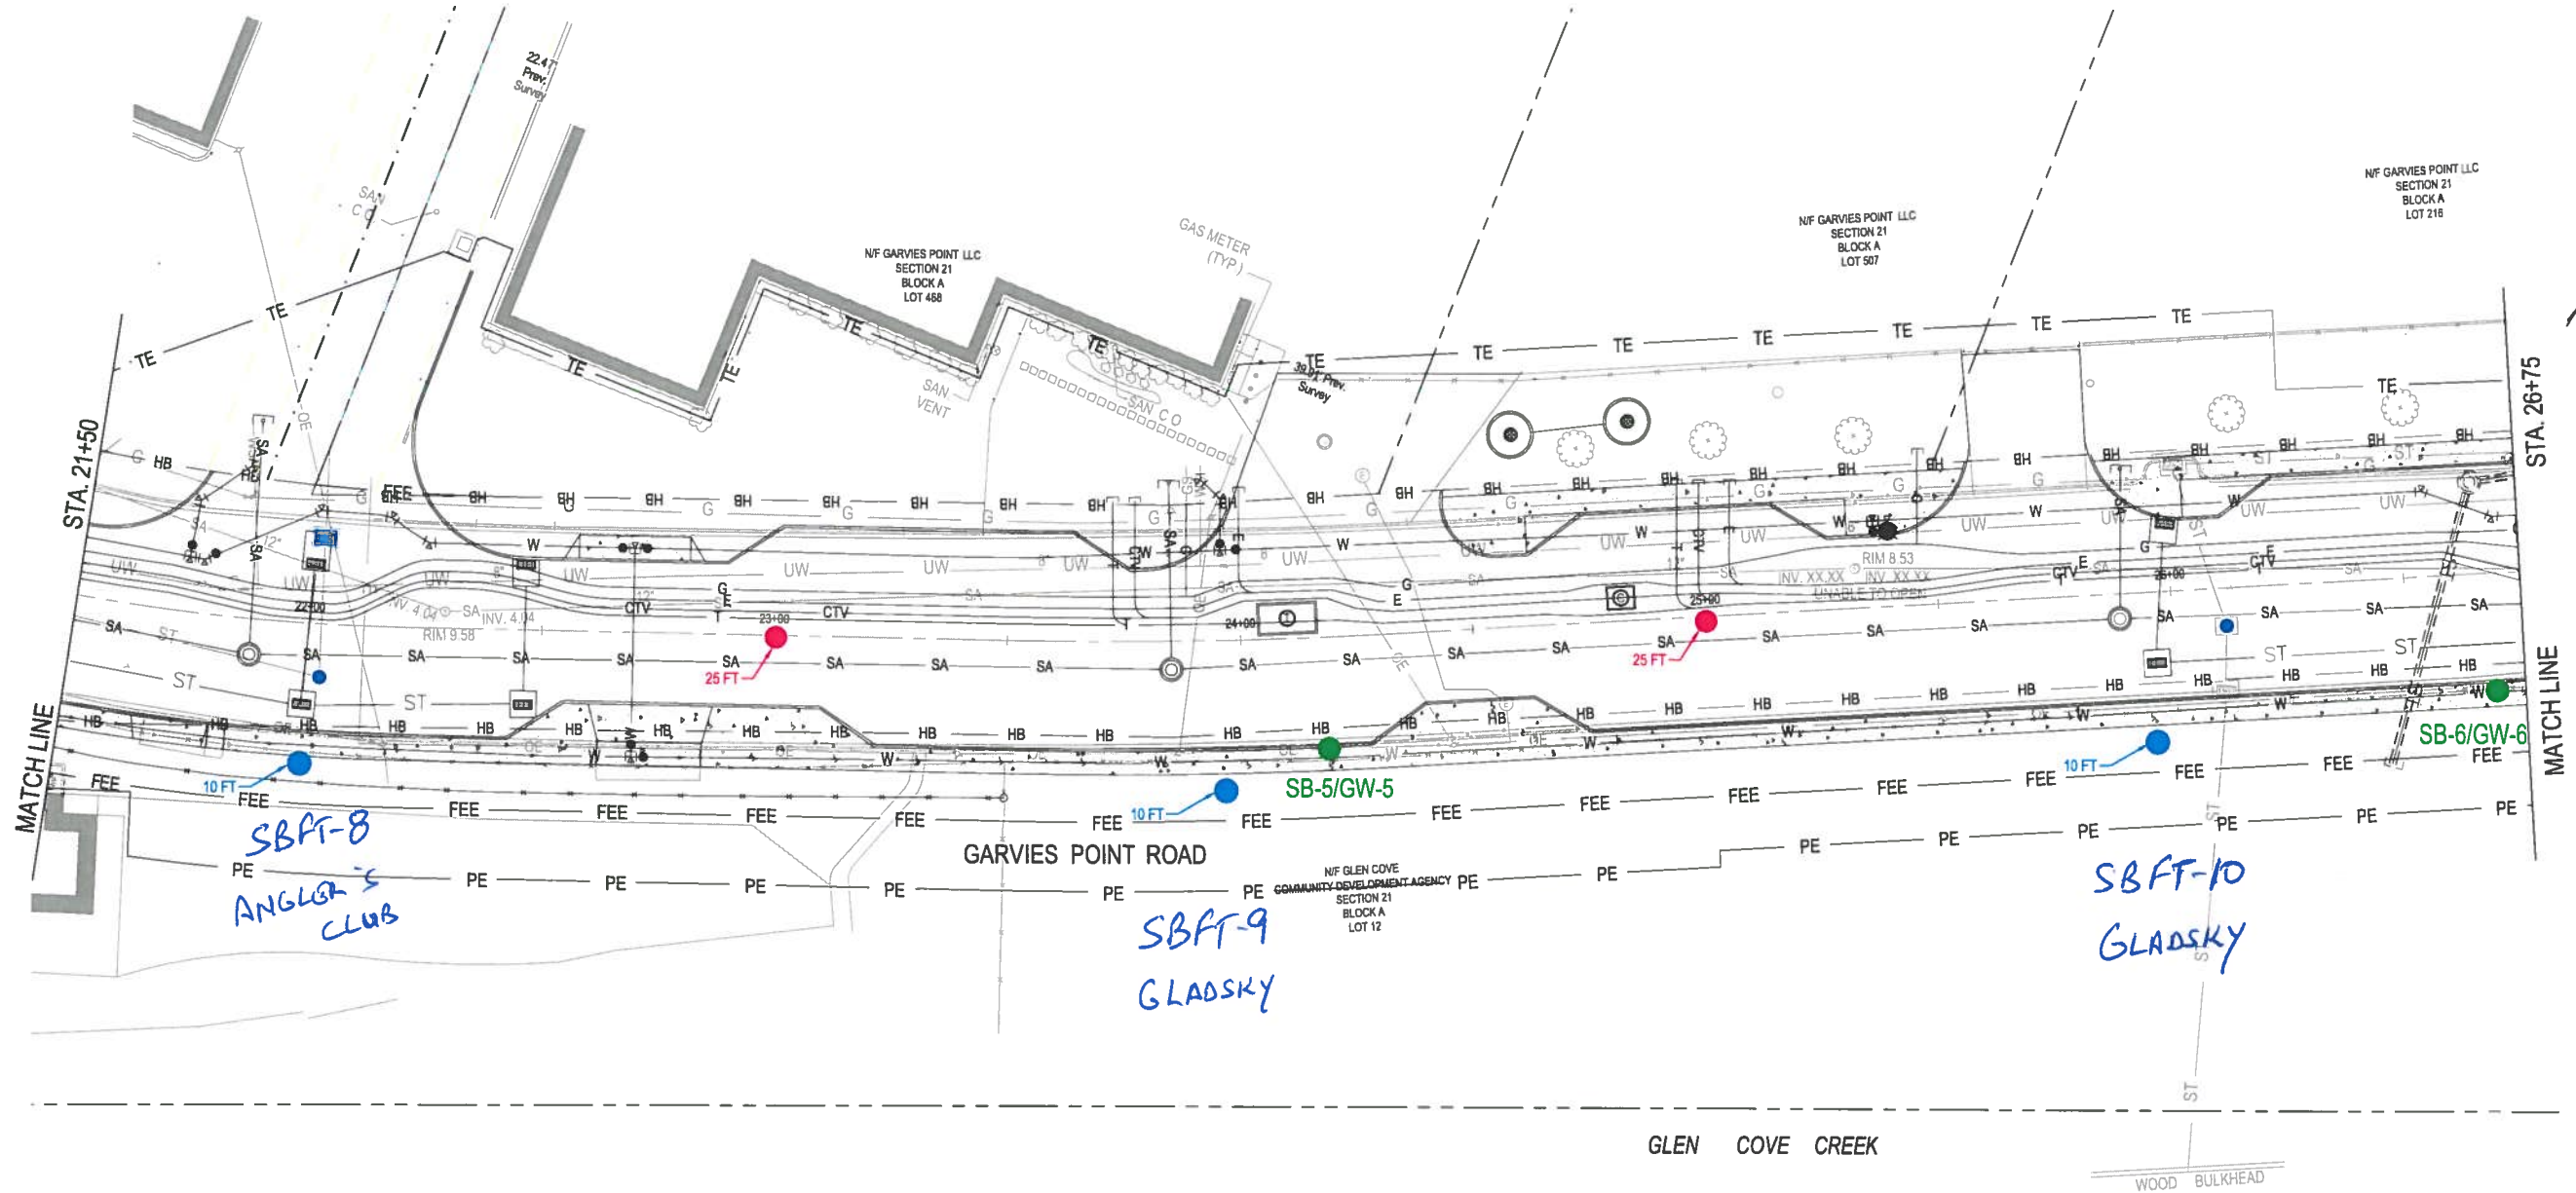



| | | | | | | | | | | | | | | | | | | | | | |
|--|---|--|---------|----------|--|---|---|-----------------|--|--|-----------|--|--|--|--|-----------|------|----------------|--|--|-------------------------------|
| PREPARED BY: ON: | ALTERED BY: ON: | | | | | | | | | | | | | | | | | | | | |
| <div style="text-align: center;">  <p>GRAPHIC SCALE</p> <p>(IN FEET)</p> <p>1 inch = 20 ft.</p> </div> <div style="text-align: right;">  </div> | | | | | | | | | | | | | | | | | | | | | |
| P.E. NYSPE LIC. NO. PARTNER DATE | <table border="1"> <tr> <td>AS BUILT REVISIONS DESCRIPTION OF WORK:</td> <td></td> <td>PIN</td> <td>BRIDGES</td> <td>CULVERTS</td> <td>ALL DIMENSIONS IN ft UNLESS OTHERWISE NOTED</td> <td>CONTRACT NUMBER</td> </tr> <tr> <td></td> <td></td> <td>PS&E DATE</td> <td></td> <td></td> <td rowspan="2"> CITY OF GLEN COVE BORING LOCATION PLAN GARVIES POINT ROAD SHEET 6 </td> <td></td> </tr> <tr> <td>SIGNATURE</td> <td>DATE</td> <td>COUNTY: NASSAU</td> <td></td> <td></td> <td>DRAWING NO. BP-6 SHEET NO.</td> </tr> </table> | AS BUILT REVISIONS DESCRIPTION OF WORK: | | PIN | BRIDGES | CULVERTS | ALL DIMENSIONS IN ft UNLESS OTHERWISE NOTED | CONTRACT NUMBER | | | PS&E DATE | | | CITY OF GLEN COVE BORING LOCATION PLAN GARVIES POINT ROAD SHEET 6 | | SIGNATURE | DATE | COUNTY: NASSAU | | | DRAWING NO. BP-6 SHEET NO. |
| AS BUILT REVISIONS DESCRIPTION OF WORK: | | PIN | BRIDGES | CULVERTS | ALL DIMENSIONS IN ft UNLESS OTHERWISE NOTED | CONTRACT NUMBER | | | | | | | | | | | | | | | |
| | | PS&E DATE | | | CITY OF GLEN COVE BORING LOCATION PLAN GARVIES POINT ROAD SHEET 6 | | | | | | | | | | | | | | | | |
| SIGNATURE | DATE | COUNTY: NASSAU | | | | DRAWING NO. BP-6 SHEET NO. | | | | | | | | | | | | | | | |
| IT IS A VIOLATION OF LAW FOR ANY PERSON, UNLESS THEY ARE ACTING UNDER THE DIRECTION OF A LICENSED PROFESSIONAL ENGINEER, ARCHITECT, LANDSCAPING ARCHITECT, OR A LAND SURVEYOR, TO ALTER AN ITEM IN ANY WAY. IF AN ITEM BEARING THE STAMP OF A LICENSED PROFESSIONAL IS ALTERED, THE ALTERING ENGINEER, ARCHITECT, LANDSCAPING ARCHITECT, OR A LAND SURVEYOR SHALL STAMP THE DOCUMENT AND INCLUDE THE NOTATION "ALTERED BY" FOLLOWED BY THEIR SIGNATURE, THE DATE OF SUCH ALTERATION, AND A SPECIFIC DESCRIPTION OF THE ALTERATION. | | | | | | NEW YORK STATE DEPARTMENT OF TRANSPORTATION REGION 10 DOCUMENT NAME: nju.sheet.cel | | | | | | | | | | | | | | | |




| | |
|---|---|
| AS BUILT REVISIONS DESCRIPTION OF WORK: <div style="border-bottom: 1px solid black; height: 1.2em; width: 100%; margin-top: 5px;"></div> <div style="border-bottom: 1px solid black; height: 1.2em; width: 100%; margin-top: 5px;"></div> <div style="border-bottom: 1px solid black; height: 1.2em; width: 100%; margin-top: 5px;"></div> | |
| <div style="border-top: 1px solid black; height: 1.2em; width: 100%; margin-bottom: 5px;"></div> SIGNATURE | <div style="border-top: 1px solid black; height: 1.2em; width: 100%; margin-bottom: 5px;"></div> DATE |
| IT IS A VIOLATION OF LAW FOR ANY PERSON, UNLESS THEY ARE ACTING UND SURVEYOR, TO ALTER AN ITEM IN ANY WAY, IF AN ITEM BEARING THE STAMP LAND SURVEYOR SHALL STAMP THE DOCUMENT AND INCLUDE THE NOTATION "A AI. ITERATION. | |

| | | | | |
|-----------|---------|----------|--|-------------------------------|
| PIN | BRIDGES | CULVERTS | ALL DIMENSIONS IN ft UNLESS OTHERWISE NOTED | CONTRACT NUMBER |
| PS&E DATE | | | CITY OF GLEN COVE BORING LOCATION PLAN GARVIES POINT ROAD SHEET 7 | DRAWING NO. PB-7 SHEET NO. |


LANDSCAPING ARCHITECT, OR A LAND ARCHITECT, LANDSCAPING ARCHITECT, OR A RATION, AND A SPECIFIC DESCRIPTION OF THE

NEW YORK STATE DEPARTMENT OF TRANSPORTATION REGION 10
DOCUMENT NAME: nys.sheetcel

NEW YORK STATE DEPARTMENT OF TRANSPORTATION REGION 10
DOCUMENT NAME: nyu_sheet.cel

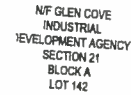

NEW YORK STATE DEPARTMENT OF TRANSPORTATION REGION 10
DOCUMENT NAME: nyu_sheet.col

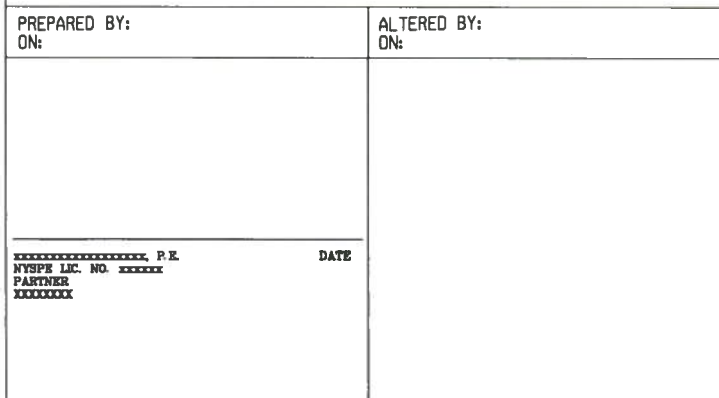

| | | | | | | |
|---|------|----------------|---------|----------|--|------------------|
| AS BUILT REVISIONS DESCRIPTION OF WORK: | | PIN | BRIDGES | CULVERTS | ALL DIMENSIONS IN Ft UNLESS OTHERWISE NOTED | CONTRACT NUMBER |
| _____ _____ _____ | | PS&E DATE | | | CITI OF GLEN COVE BORING LOCATION PLAN HERB HILL ROAD SHEET 9 | DRAWING NO. BP-9 |
| SIGNATURE | DATE | COUNTY: NASSAU | | | | SHEET NO. |
| IT IS A VIOLATION OF LAW FOR ANY PERSON, UNLESS THEY ARE ACTING UNDER THE DIRECTION OF A LICENSED PROFESSIONAL ENGINEER, ARCHITECT, LANDSCAPING ARCHITECT, OR A LAND SURVEYOR, TO ALTER AN ITEM IN ANY WAY. IF AN ITEM BEARING THE STAMP OF A LICENSED PROFESSIONAL IS ALTERED, THE ALTERING ENGINEER, ARCHITECT, LANDSCAPING ARCHITECT, OR A LAND SURVEYOR SHALL STAMP THE DOCUMENT AND INCLUDE THE FOLLOWING INFORMATION: | | | | | NEW YORK STATE DEPARTMENT OF TRANSPORTATION REGION 10 PROJECT NAME: | |